

\\VHB\PROJ\WAT-LD\12109.00\CAD\LD\PLANSET\SPSR SUBMISSION\12109_TB-SPSR
Saved Wednesday, October 01, 2014 11:38:33 AM JIMAYER Plotted Thursday, January 31, 2014 7:44:50 AM Mayer, Joclyn


c | d | p
1601 Trapelo Road
Suite 280
Waltham, MA 02451



Vanasse Hangen Brustlin, Inc.
Transportation
Land Development
Environmental Services
101 Walnut Street, P.O. Box 9151
Watertown, Massachusetts 02471
617.924.1770 • FAX 617.924.2286

GROUNDVIEW
landscape architecture
urban design
5 Dell Street
Somerville, MA 02145
617/548.9688

CUBE 3
STUDIO
architecture interiors planning
360 Merrimack Street Lawrence, MA 01843
phone: 978.989.9900 www.cube3studio.com

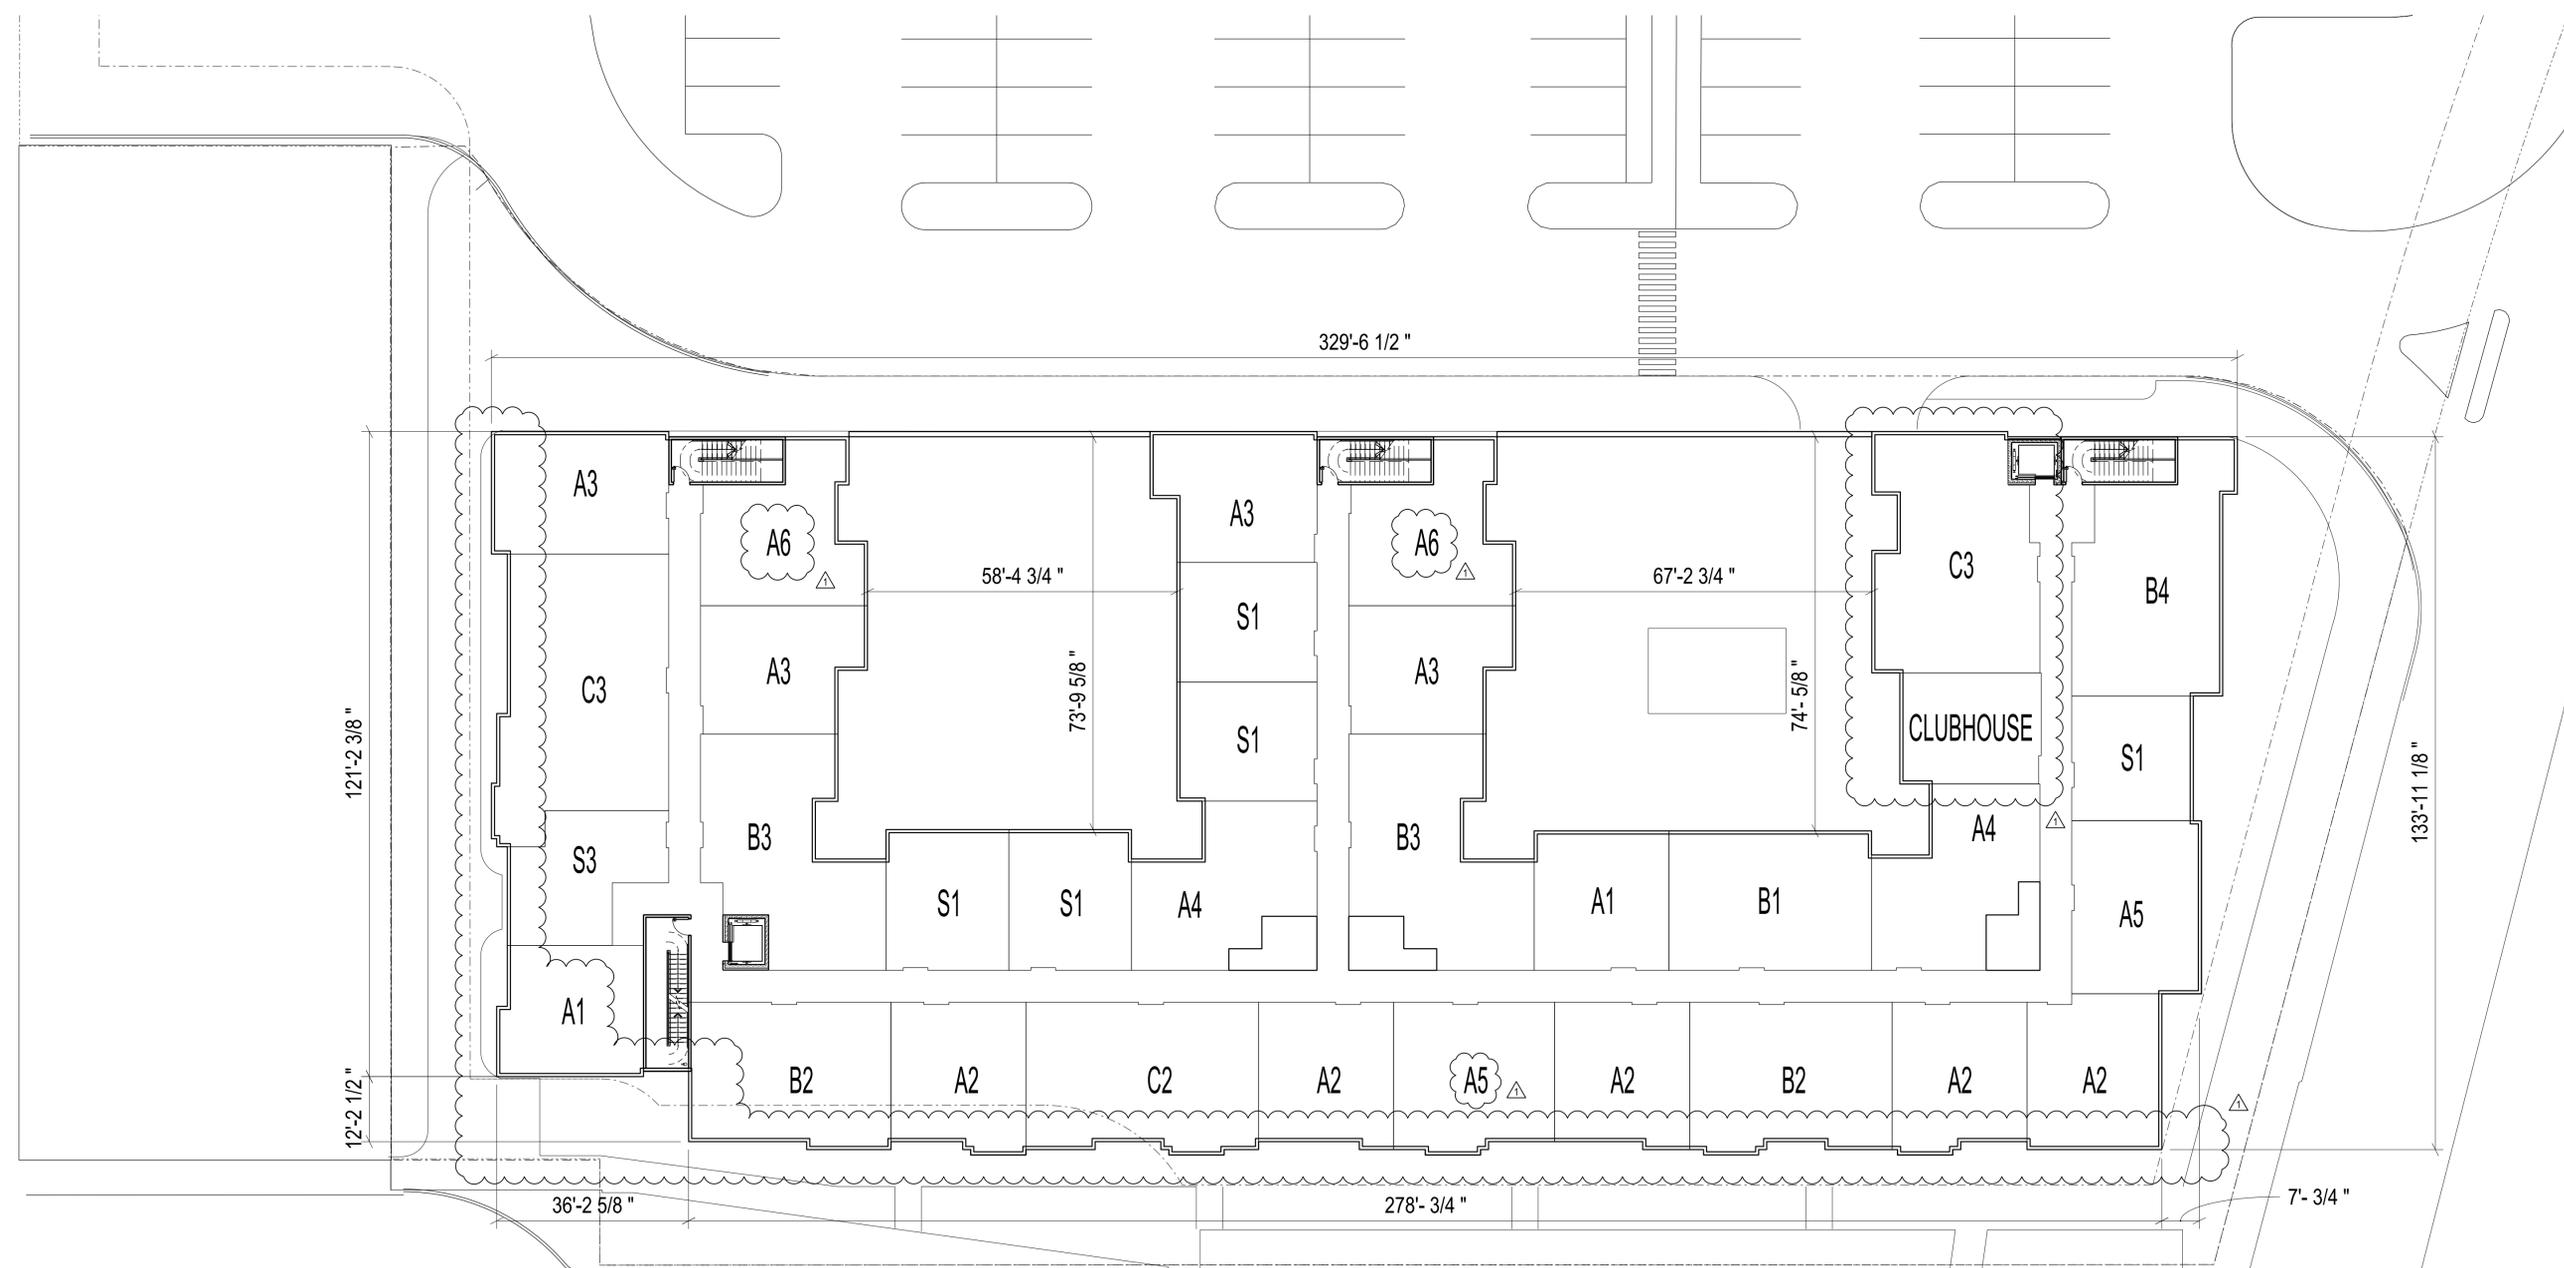

SECOND FLOOR SUMMARY:
31,960 SF
32 UNITS
CLUBHOUSE 1,342 SF

PLAN LEGEND:
S - STUDIO UNITS
A - 1 BED UNITS
B - 2 BED UNITS
C - 3 BED UNITS


PROJECT SUMMARY:
107,597 SF
75 UNITS

No.	Revision	Date	Appr.

Designed by: _____ Drawn by: _____ Checked by: _____
CAD checked by: _____ Approved by: _____
Scale: _____ Date: October 1, 2014
Project Title: _____

Proposed Residential Development
60-70 Cross Street East
Somerville, Massachusetts
Issued for
Special Permit with Site Plan Review

Not Approved for Construction
Drawing Title
Second Floor Plan

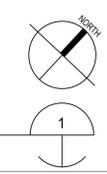

Second Floor Plan
SCALE: 1/16" = 1'-0"

Drawing Number
A-101
Sheet 2 of 5
Project Number
12109.00



Vanasse Hangen Brustlin, Inc.

Transportation
Land Development
Environmental Services

101 Walnut Street, P.O. Box 9151
Watertown, Massachusetts 02471
617.924.1770 • FAX 617.924.2286

GROUNDVIEW

landscape architecture
urban design

5 Dell Street
Somerville, MA 02145
617/548.9688

CUBE 3
STUDIO

architecture interiors planning

360 Merrimack Street Lawrence, MA 01843
phone: 978.989.9900 www.cube3studio.com

△	Elevation Revisions	Date	Appvd.
		10/15/14	

Designed by	Drawn by	Checked by	Appvd.
CAD checked by	Approved by		
Scale	Date	October 1, 2014	


Proposed Residential Development

60-70 Cross Street East
Somerville, Massachusetts


Issued for
Special Permit with Site Plan Review

Not Approved for Construction

Building Elevations

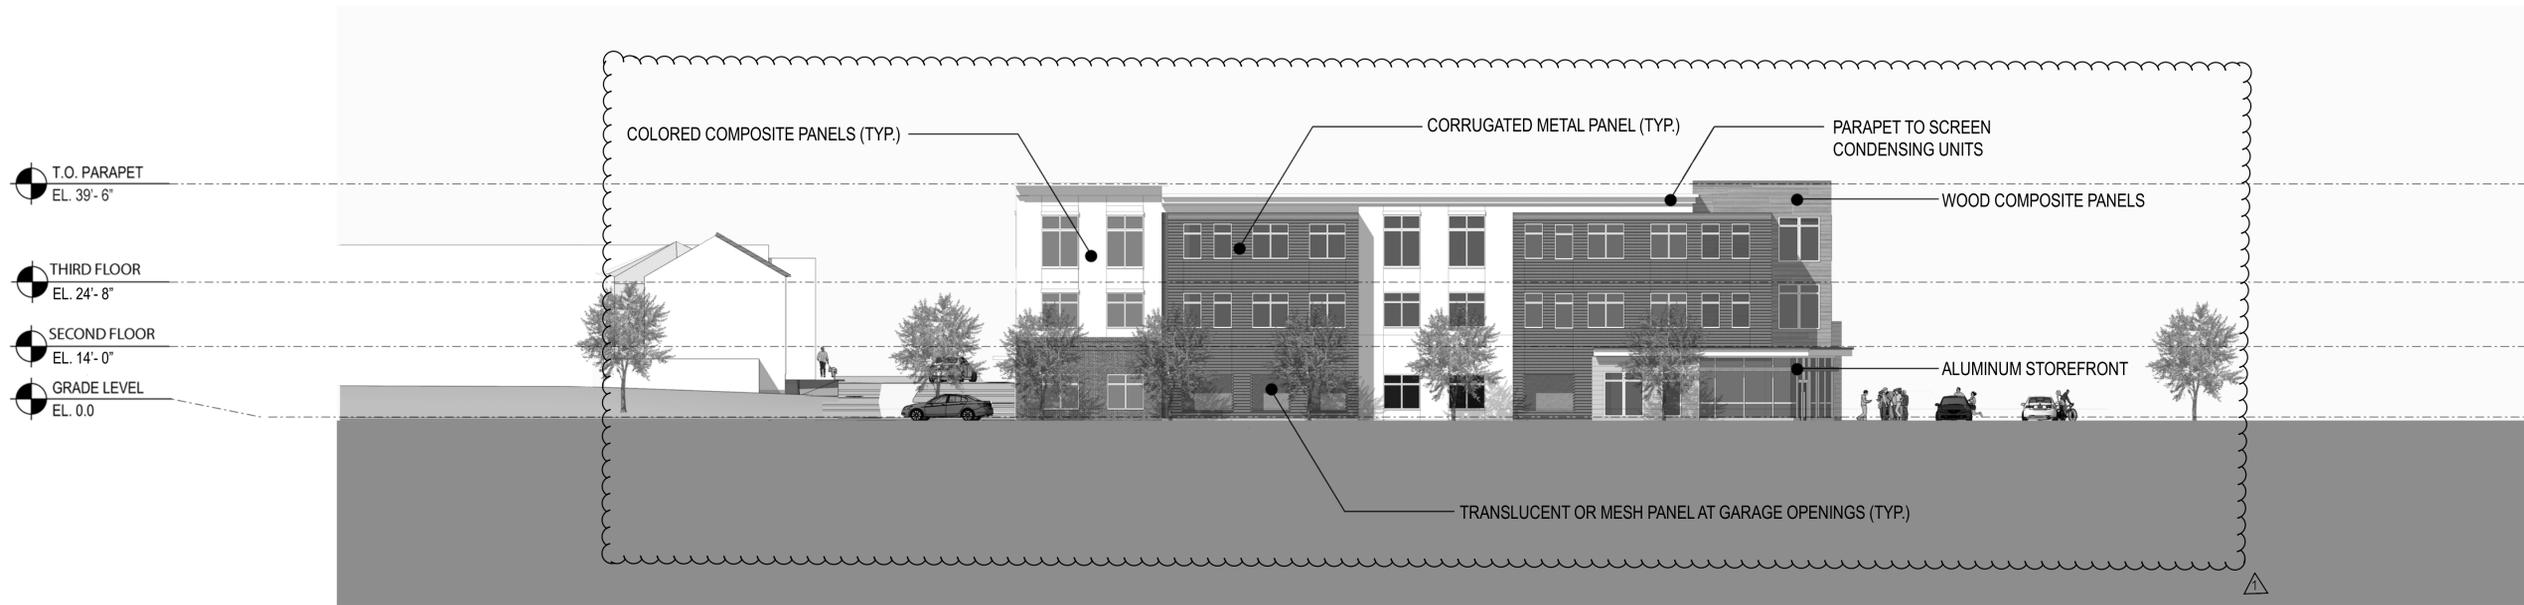

Northeast Elevation

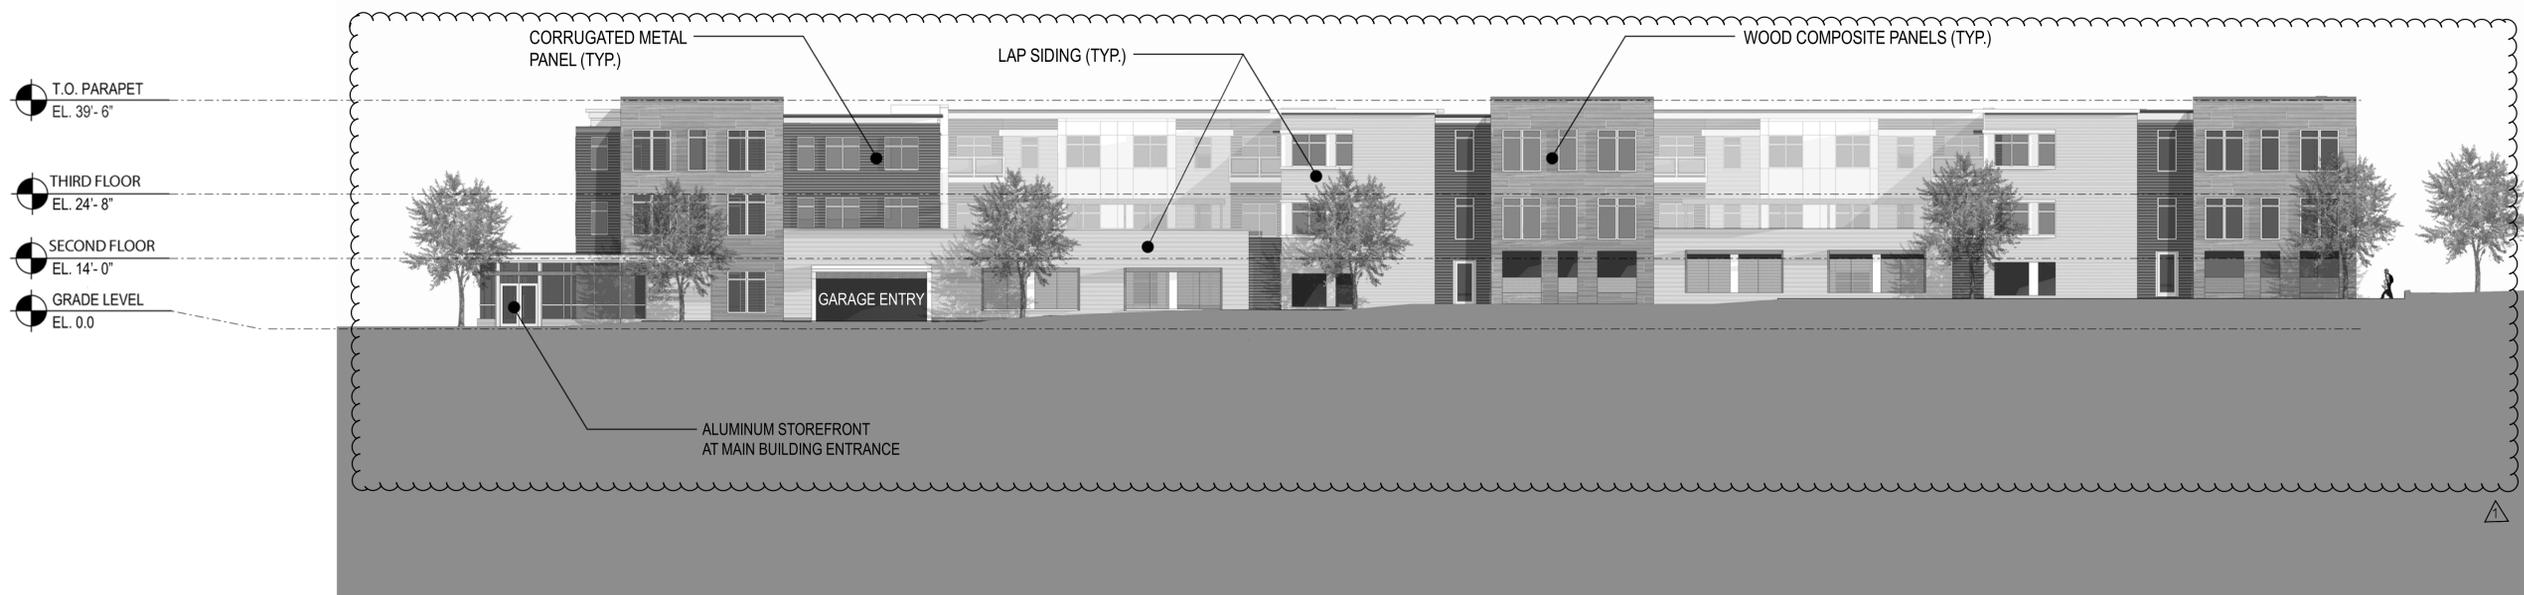

Northwest Elevation

Drawing Number

A-200

Sheet 4 of 5

Project Number 12109.00



Vanasse Hangen Brustlin, Inc.


Transportation
Land Development
Environmental Services

101 Walnut Street, P.O. Box 9151
Watertown, Massachusetts 02471
617.924.1770 • FAX 617.924.2286


GROUNDVIEW

landscape architecture
urban design

5 Dell Street
Somerville, MA 02145
617/548.9688

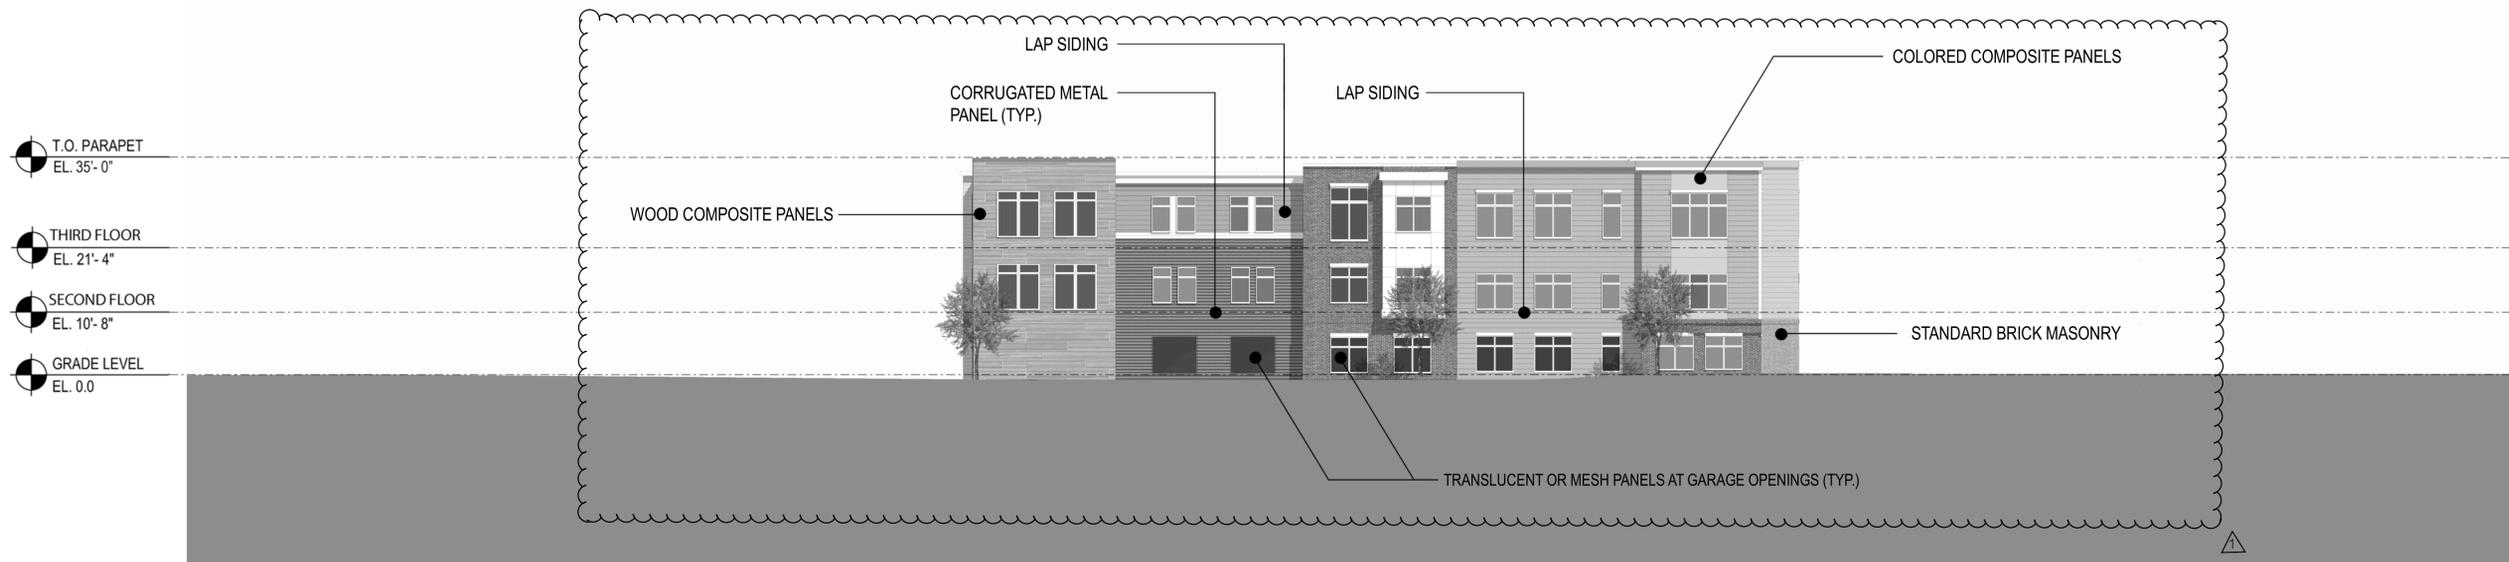

Southwest Elevation

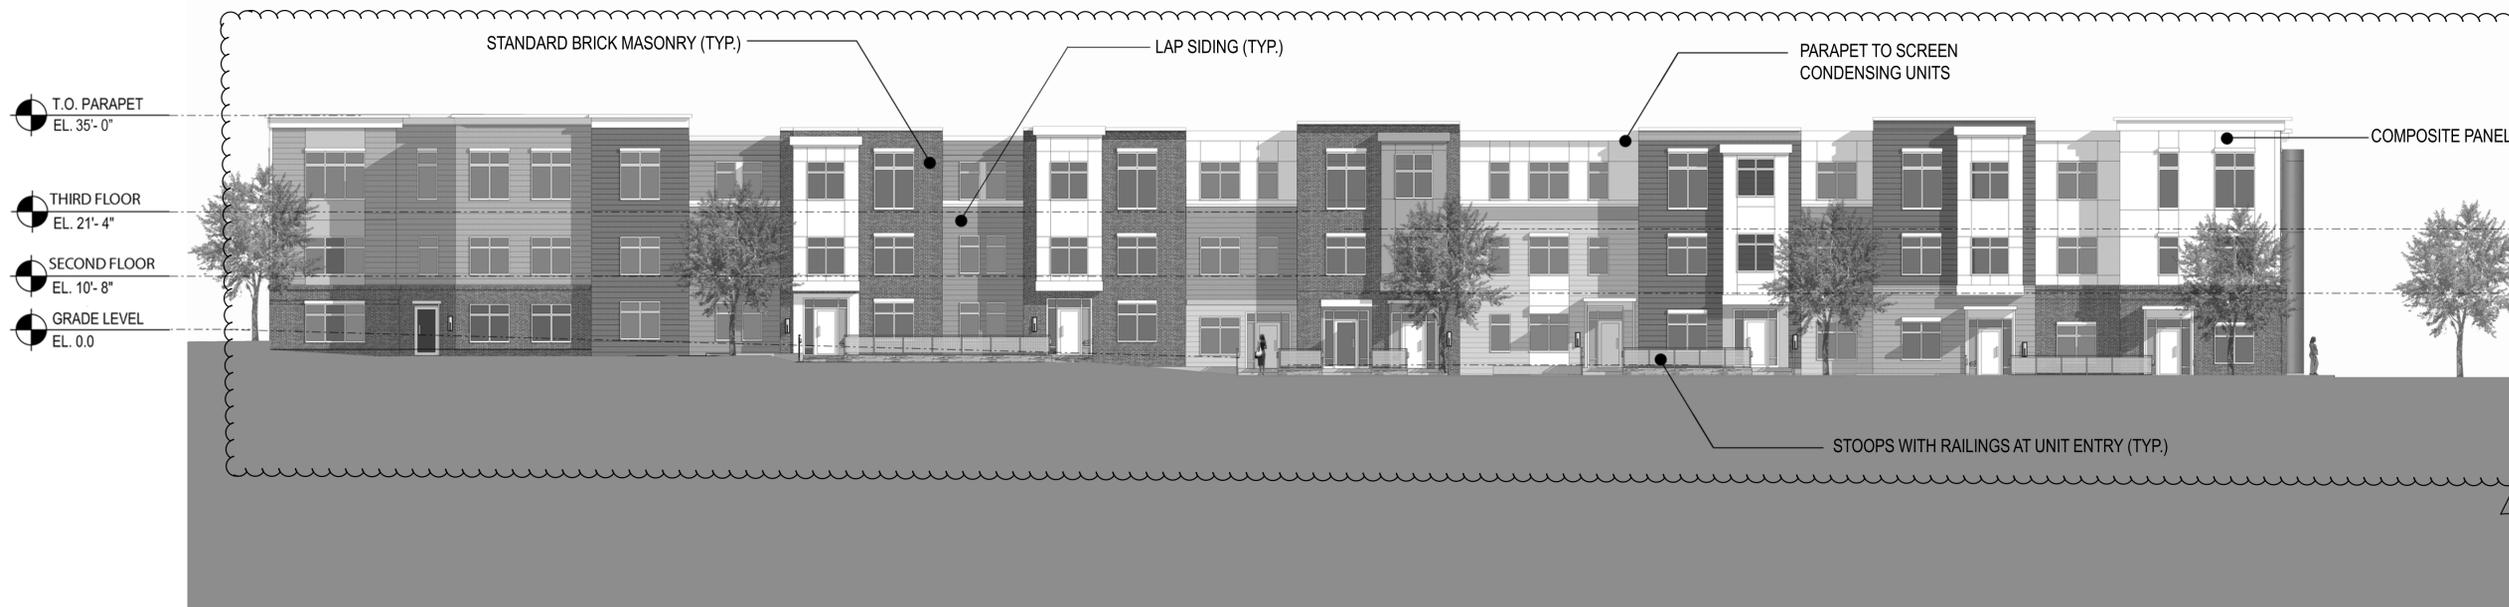

Southeast Elevation

Revision	Date
1	10/15/14

No.	Revision	Date	Appvd.

Project Title
 Designed by _____ Drawn by _____ Checked by _____
 CAD checked by _____ Approved by _____
 Scale _____ Date **October 1, 2014**

Proposed Residential Development

60-70 Cross Street East
Somerville, Massachusetts

Issued for
Special Permit with Site Plan Review

Not Approved for Construction
Drawing Title

Building Elevations